

Allt Dearg and Sròndoire Community Wind Farms


- S1 Sròndoire wind turbine location
- T1 Allt Dearg as built wind turbine location
- As built access track
- Ormsary track
- Crane hardstanding
- Existing borrow pit
- Allt Dearg substation
- Sròndoire substation

Wind Turbine UK OS Grid Co-ordinates:

Sròndoire Wind Turbines:
 S1: NR 8255 7693
 S2: NR 8292 7679
 S3: NR 8285 7643

Allt Dearg Wind Turbines:
 T1: NR 8174 7619
 T2: NR 8190 7644
 T3: NR 8195 7625
 T4: NR 8205 7667
 T5: NR 8215 7648
 T6: NR 8220 7627
 T7: NR 8235 7673
 T8: NR 8239 7657
 T9: NR 8245 7630
 T10: NR 8260 7671
 T11: NR 8265 7651
 T12: NR 8263 7630

Site Access Track Entrance off A83 Public Road:
 NR 8496 7953

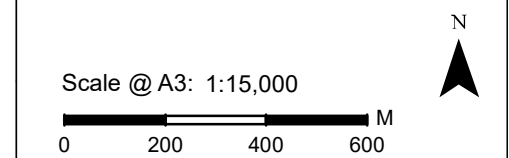

Date: 21.04.2016 | Drawn: TC | Checked: SM | Rev: B
 Ref: SRD SK31 Site Location Plan

Allt Dearg and Sròndoire - Site Location Plan

